THIS DRAWING IS UNPUBLISHED. RELEASED FOR PUBLICATION -,- .
© COPYRIGHT - BY TYCO ELECTRONICS CORPORATION. ALL RIGHTS RESERVED.

LOC	DIST
AD	00

REVISIONS

P	LTR	DESCRIPTION	DATE	DWN	APVD
	L1	REVISED PER ECO-09-020774	08SEP09	KK	AEG

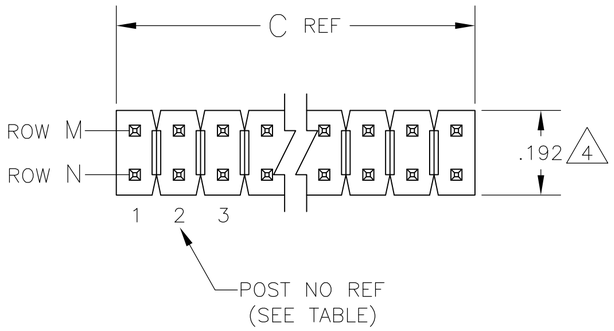

1. TRUE POSITION TOLERANCE OF THE POST TIPS APPLIES WHEN THE HEADER IS HELD FLAT AGAINST THE PRINTED CIRCUIT BOARD.

2 THE NOTED DIMENSIONS APPLY AT THE INTERSECTION OF THE POST AND HOUSING.

3 RETENTION FEATURES ON SOLDER TAILS, LOCATED AT MANUFACTURERS OPTION.

4 FOR 2 POSITION PART ONLY, THE NOTED DIMENSION IS .184±.016

5 ⌖ .020 Ⓜ FOR KINKED TAILS

6 OBSOLETE PARTS: OBSOLETE CIS STREAMLINING PER D.RENAUD/D.SINISI

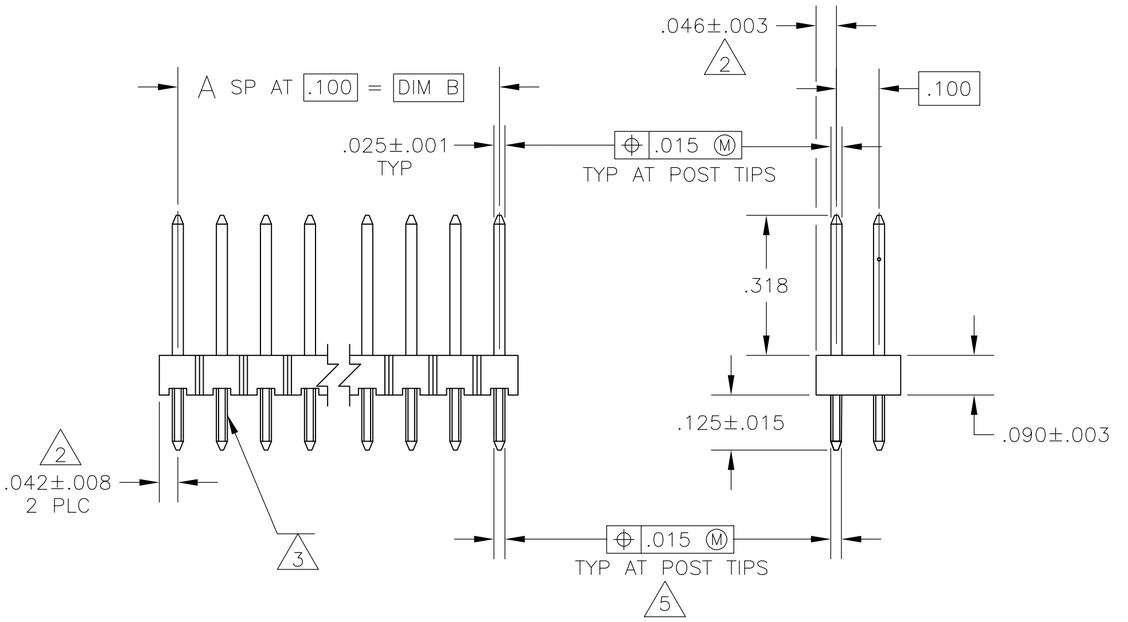

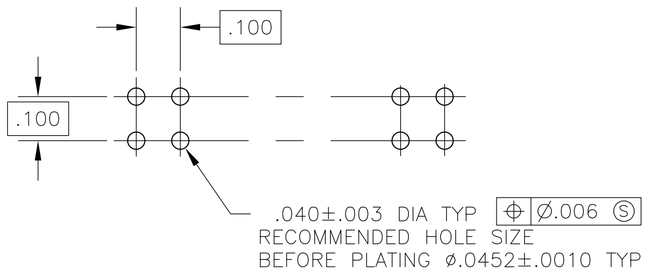

RECOMMENDED HOLE LAYOUT

3.984	3.900	39	80	2-104434-0
~~2.984~~	~~2.900~~	~~29~~	~~60~~	~~1-104434-9~~
~~2.484~~	~~2.400~~	~~24~~	~~50~~	~~1-104434-8~~
1.984	1.900	19	40	1-104434-7
~~1.684~~	~~1.600~~	~~16~~	~~34~~	~~1-104434-6~~
~~1.484~~	~~1.400~~	~~14~~	~~30~~	~~1-104434-5~~
~~1.384~~	~~1.300~~	~~13~~	~~28~~	~~1-104434-4~~
~~1.284~~	~~1.200~~	~~12~~	~~26~~	~~1-104434-3~~
~~1.184~~	~~1.100~~	~~11~~	~~24~~	~~1-104434-2~~
~~1.084~~	~~1.000~~	~~10~~	~~22~~	~~1-104434-1~~
~~.984~~	~~.900~~	~~9~~	~~20~~	~~1-104434-0~~
~~.884~~	~~.800~~	~~8~~	~~18~~	~~104434-9~~
~~.784~~	~~.700~~	~~7~~	~~16~~	~~104434-8~~
~~.684~~	~~.600~~	~~6~~	~~14~~	~~104434-7~~
~~.584~~	~~.500~~	~~5~~	~~12~~	~~104434-6~~
~~.484~~	~~.400~~	~~4~~	~~10~~	~~104434-5~~
~~.384~~	~~.300~~	~~3~~	~~8~~	~~104434-4~~
~~.284~~	~~.200~~	~~2~~	~~6~~	~~104434-3~~
~~.184~~	~~.100~~	~~1~~	~~4~~	~~104434-2~~
~~.084~~	—	—	~~2~~	~~104434-1~~
C	B	A	NO OF POSN	ASSEMBLY PART NUMBER

6 OBSOLETE

6 OBSOLETE

6 SUPERSEDED

6 OBSOLETE

6 SUPERSEDED

104434

THIS DRAWING IS A CONTROLLED DOCUMENT.

DIMENSIONS: INCHES

TOLERANCES UNLESS OTHERWISE SPECIFIED:
0 PLC ± -
1 PLC ± -
2 PLC ± -
3 PLC ± .005
4 PLC ± -
ANGLES ± -

MATERIAL HOUSING: FLAME RETARDANT THERMOPLASTIC COLOR-BLACK
POST: PHOSPHOR BRONZE

FINISH .000100-.000200 MATTE TIN-LEAD OVER .000050 NICKEL ON ENTIRE POST

DWN	H MOLL	28JUN88
CHK	R FEIDT	28JUN88
APVD	R FEIDT	28JUN88
PRODUCT SPEC	—	
APPLICATION SPEC	—	
WEIGHT	—	

Tyco Electronics
Tyco Electronics Corporation
Harrisburg, Pa 17105-3608

NAME
HEADER ASSY, MOD II,
BREAKAWAY, DBL ROW,.100X.100CL, VERT,
.025 SQ POSTS, WITH RETENTION FEATURE

SIZE	CAGE CODE	DRAWING NO	RESTRICTED TO
A2	00779	C-104434	—

CUSTOMER DRAWING | SCALE 4:1 | SHEET 1 OF 1 | REV L1